


AROCO BIFOLD DOOR L/H

FINAL STOCK
 * = No more can be supplied once stock is depleted

RED LINE
 Indicates NO LONGER AVAILABLE

Blue Text
 Indicates USE THIS NEW NUMBER

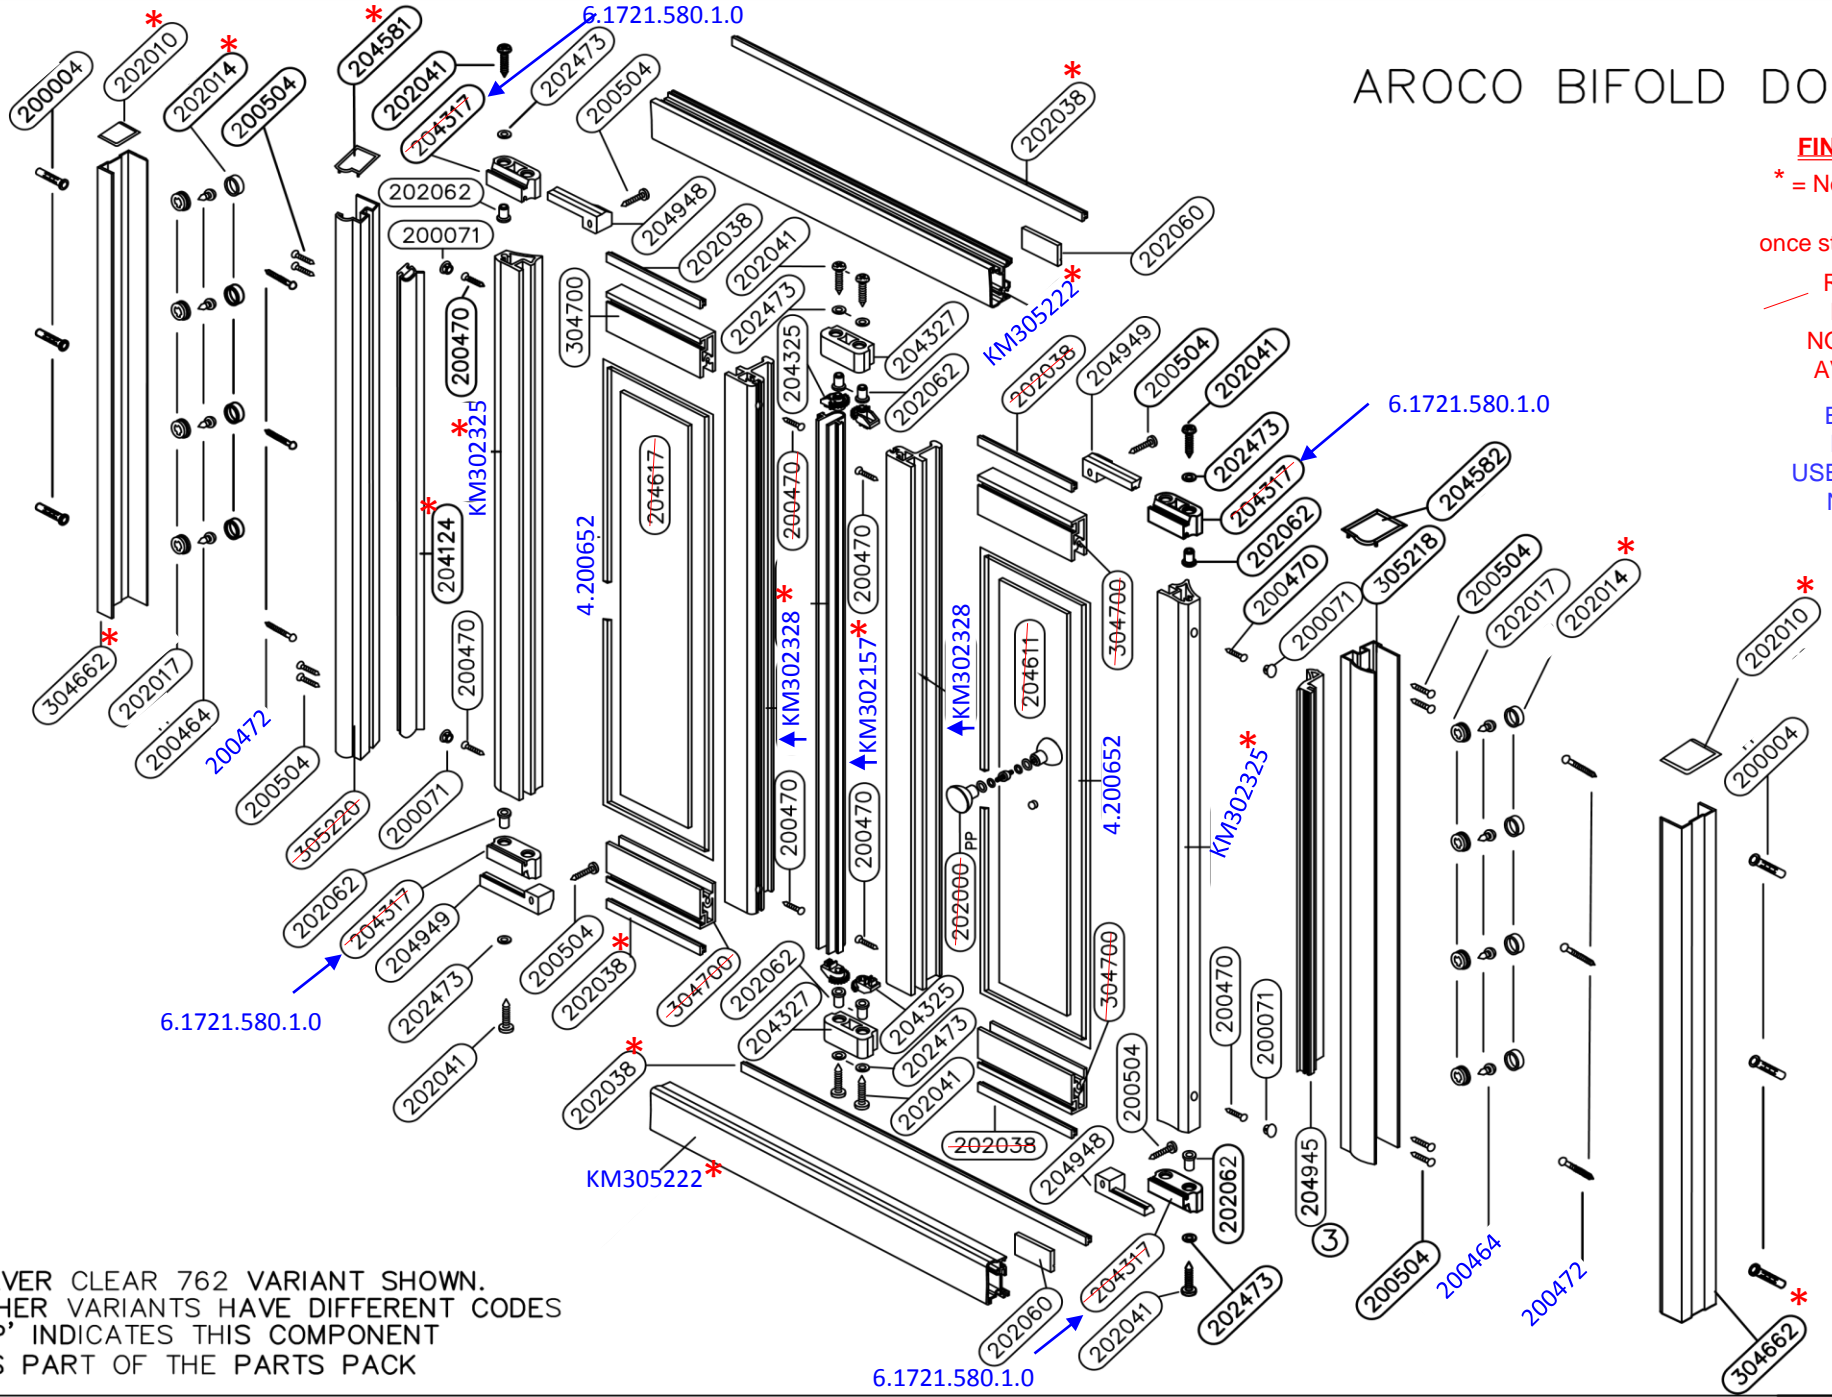

SILVER CLEAR 762 VARIANT SHOWN.
 OTHER VARIANTS HAVE DIFFERENT CODES
 'PP' INDICATES THIS COMPONENT
 IS PART OF THE PARTS PACK